

**RESOLUTION NO. 2017-2**

**A RESOLUTION OF THE VILLAGE COUNCIL OF THE  
VILLAGE OF KEY BISCAIYNE, FLORIDA, DESIGNATING  
THE NORTHERN PORTION OF THE VILLAGE GREEN  
PARK AS A DOG PARK; PROVIDING FOR  
IMPLEMENTATION; AND PROVIDING FOR AN  
EFFECTIVE DATE**

**WHEREAS**, the parks in the Village of Key Biscayne (“Village”) provide residents and the public with recreational spaces for their use and enjoyment; and

**WHEREAS**, on August 30, 2016, the Village Council adopted Ordinance No. 2016-8, amending Chapter 19, Section 19-9 of the Village Code, regarding the presence of dogs and other domestic animals within Village parks; and

**WHEREAS**, in accordance with Section 19-9 of the Village Code, as amended, the Village Council wishes to designate the northern portion of the Village Green Park as a Village park where dogs are permitted; and

**WHEREAS**, the Village Council finds that this Resolution is in the best interest and welfare of the residents of the Village.

**NOW, THEREFORE, BE IT RESOLVED BY THE COUNCIL OF THE VILLAGE OF KEY BISCAIYNE, FLORIDA, AS FOLLOWS:**

**Section 1. Recitals Adopted.** That each of the recitals stated above is hereby adopted and confirmed.

**Section 2. Designating the Northern Portion of Village Green Park as a Dog Park.** In accordance with Section 19-9 of the Village Code, as amended by Ordinance No. 2016-9, the Village Council hereby designates the northern portion of Village Green Park, as depicted in Exhibit “A” attached hereto and incorporated herein, as a dog park.

**Section 3. Access to paved Areas within the Village Green.** Dogs on leashes are permitted within those paved areas within the Village Green Park as depicted on Exhibit “B”.

**Section 4. Implementation.** The Village Manager is hereby authorized to take any and all action which is reasonably necessary to implement the purpose of this Resolution. The Village Manager is further authorized to adopt reasonable rules and regulations pertaining to the use and operation of the designated dog park.

**Section 5.**     **Effective Date.** This Resolution shall be effective immediately upon adoption hereof.

PASSED AND ADOPTED this 10<sup>th</sup> day of January, 2017.

  
MAYOR MAYRA PEÑA LINDSAY

ATTEST:





CONCHITA H. ALVAREZ, MMC, VILLAGE CLERK

APPROVED AS TO FORM AND  
LEGAL SUFFICIENCY

  
VILLAGE ATTORNEY



AS-BUILT SURVEY  
KEY BISCAIYNE DOG PARK, VILLAGE GREEN PARK

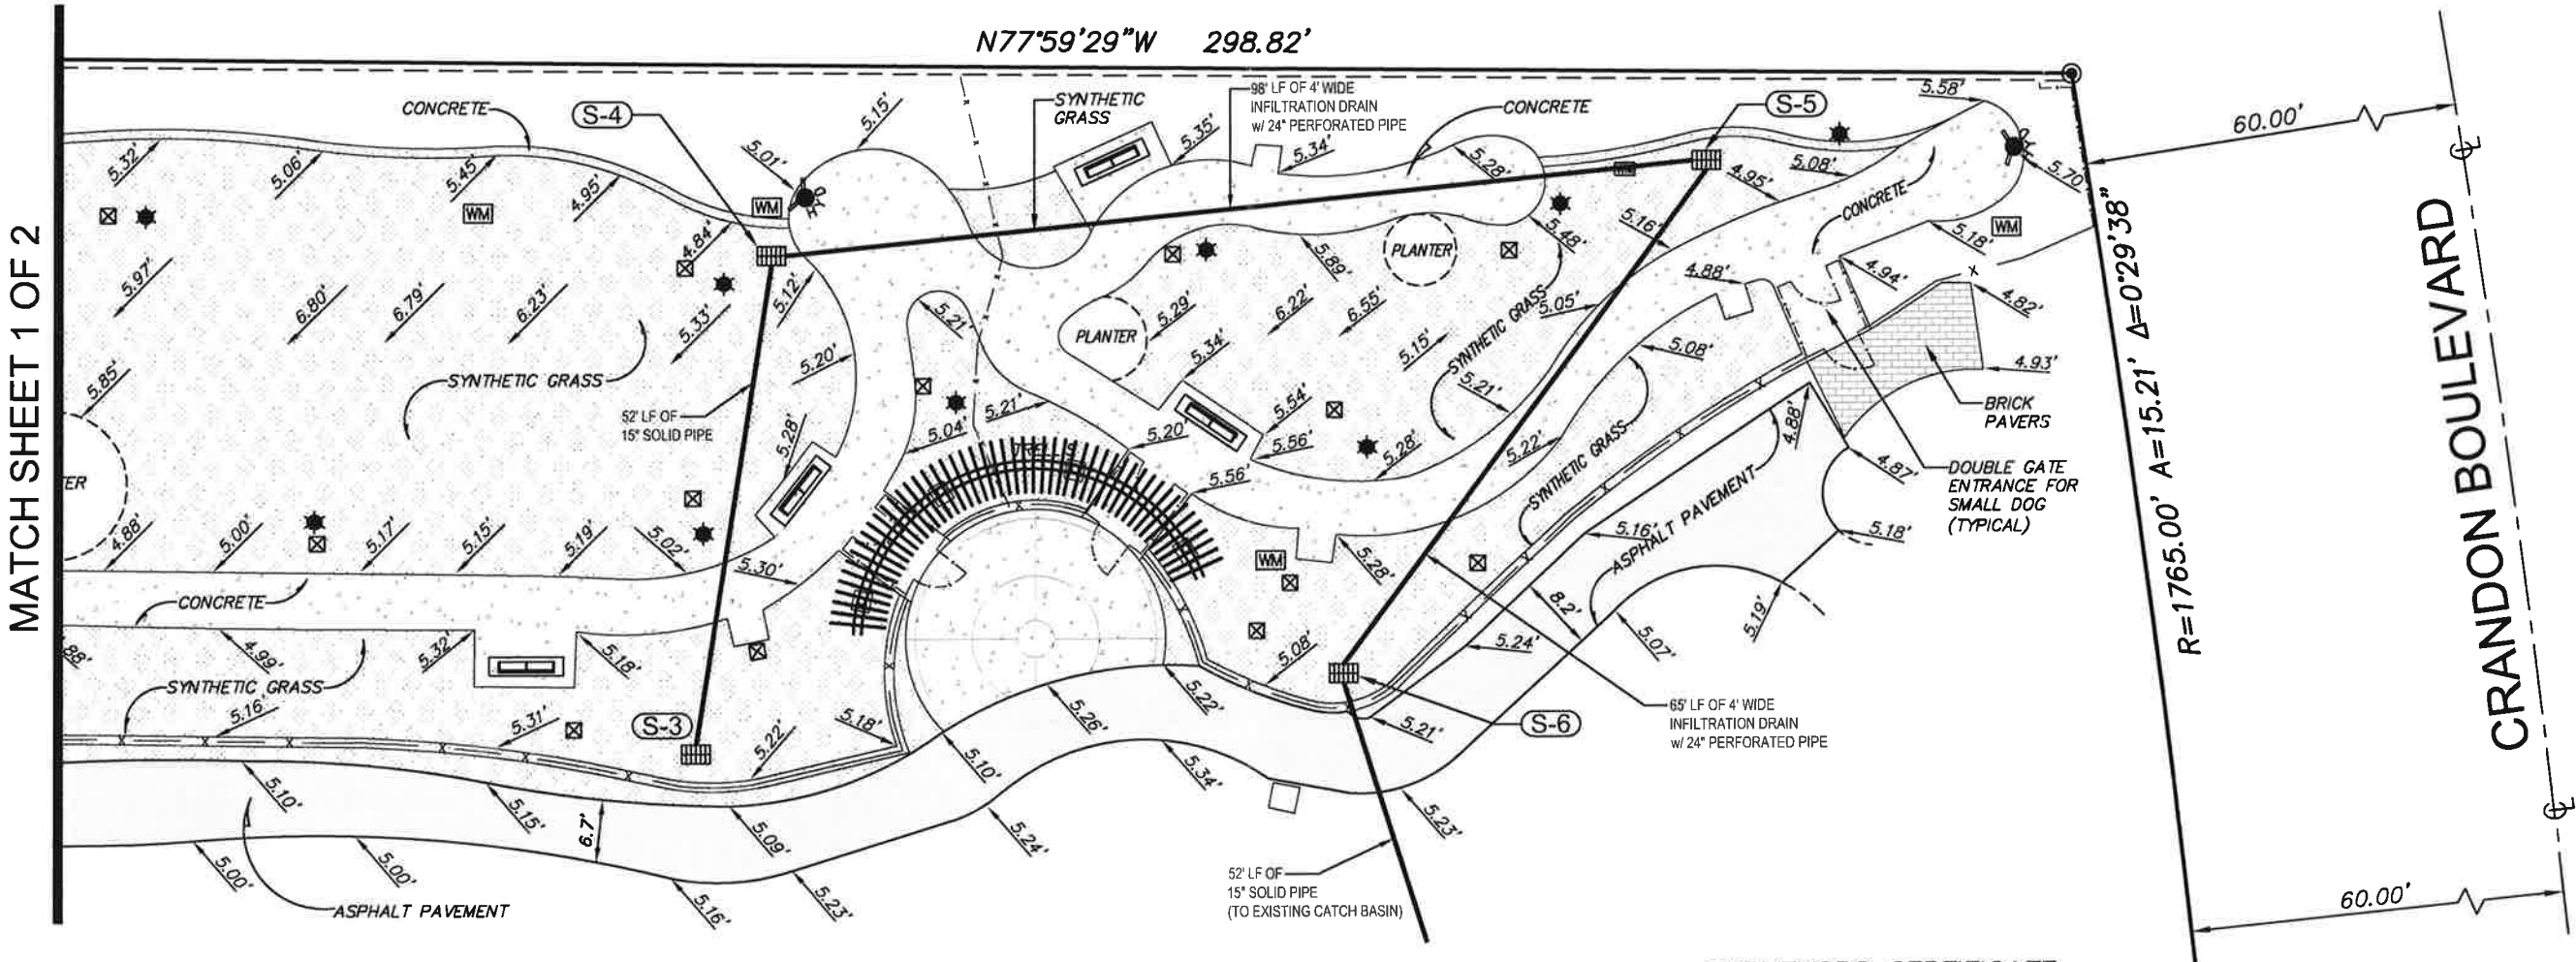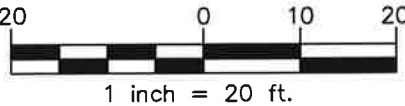

MATCH SHEET 1 OF 2

SYMBOLS

LEGEND

A=Arc Length  
CL = Center Line  
CONC. = Concrete  
Δ = Delta  
LF. = Linear Feet  
N.G.V.D. = National Geodetic Vertical Datum  
R = Radius

- BENCH
- ELECTRIC BOX
- CATCH BASIN
- WATER METER
- LIGHT POLE
- FIRE HYDRANT
- EXISTING ELEVATION
- CHAIN LINK FENCE

SURVEYORS NOTES:  
1. This is not a Land Survey.  
2. Elevations if any, shown hereon are relative to National Geodetic Vertical Datum.  
3. Not valid unless sealed with an embossed surveyor's seal.

SURVEYORS CERTIFICATE:  
I HEREBY CERTIFY: That the attached AS-BUILT SURVEY is correct to the best of my knowledge and belief as recently surveyed under my direction, and meets the intent of the Minimum Technical Standards set forth by the Florida Board of Professional Surveyors and Mappers in Chapter 61G17-6 Florida Administrative Code, pursuant to Section 472.027, Florida.

Michael Carozza  
Professional Surveyor and Mapper  
State of Florida, No. 6965

Not valid without the signature and the original raised seal of a Florida Licensed Surveyor and Mapper.

No.	Date	Description

VILLAGE OF KEY BISCAIYNE  
88 WEST MCINTYRE STREET  
KEY BISCAIYNE BLVD. , FL. 33149

MPG TECHNICAL GROUP CORP.  
908 S.W. 141st Avenue, Miami, Florida 33184  
Ph. (305) 559-9043 Fax. (305)559-8914  
No. LB 6932



CHECKED BY: M.C.
DRAWN BY: ELF.
FIELD DATE: 11/24/2016
DATE: 12/07/2016
SCALE: 1" = 20'

SHEET:  
2  
OF 2



EXHIBIT "A"

AS-BUILT SURVEY  
KEY BISCAIYNE DOG PARK, VILLAGE GREEN PARK

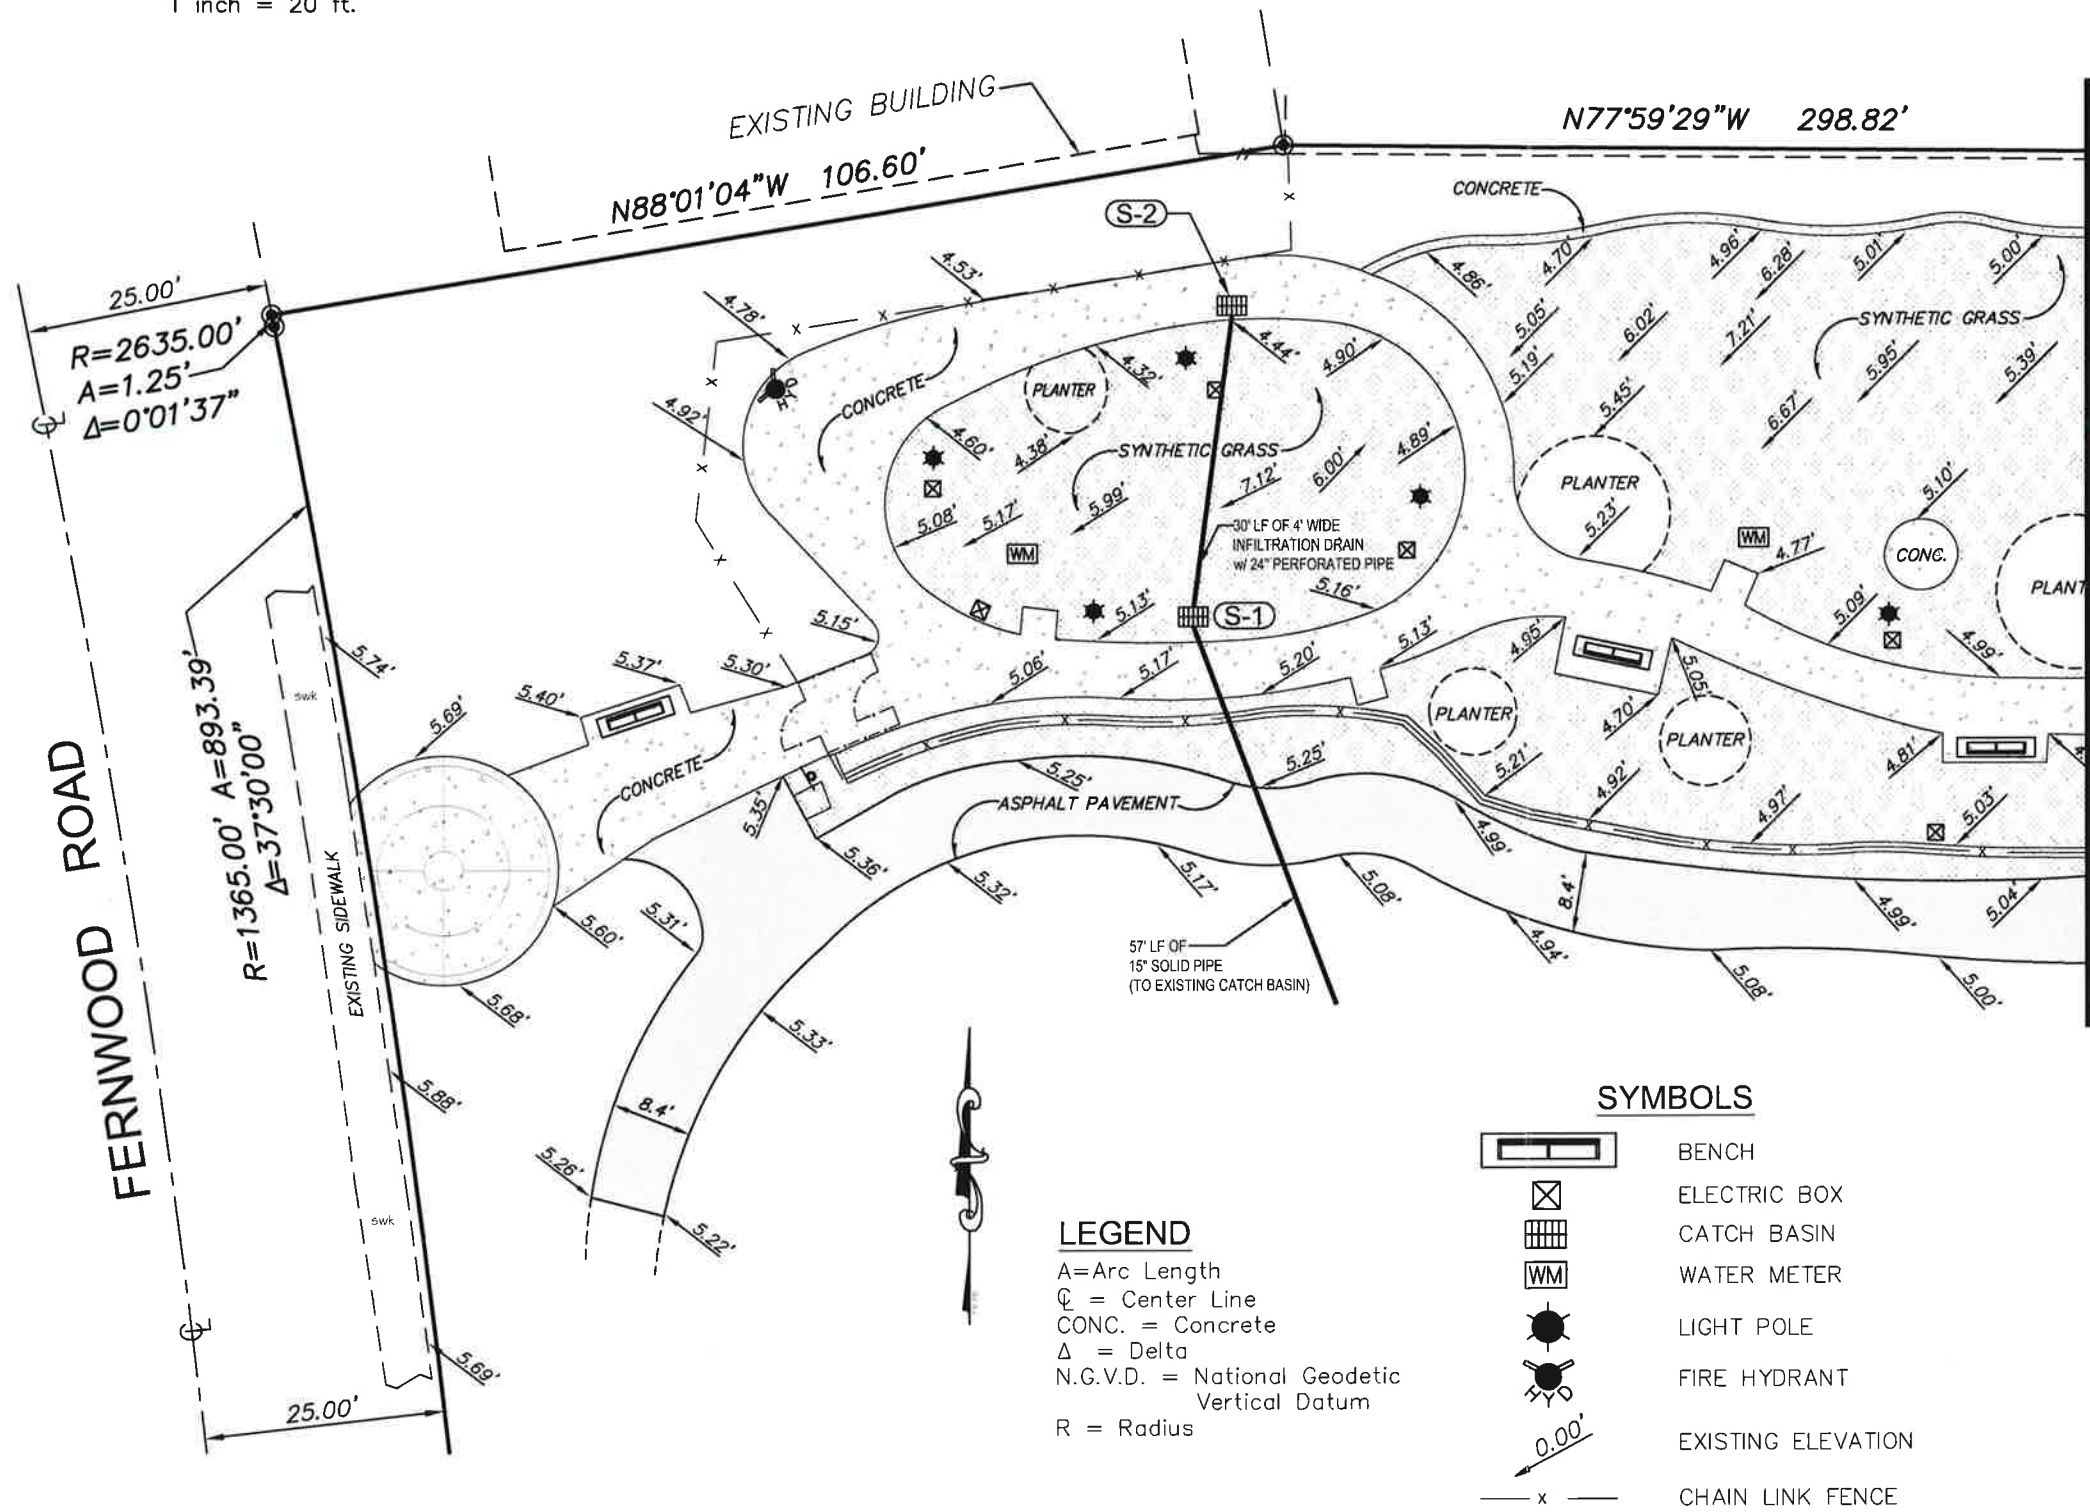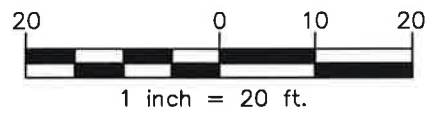

LOCATION MAP  
NOT TO SCALE

- SURVEYORS NOTES:**
1. This is not a Land Survey.
  2. Elevations if any, shown hereon are relative to National Geodetic Vertical Datum.
  3. Not valid unless sealed with an embossed surveyor's seal.

**SURVEYORS CERTIFICATE:**

I HEREBY CERTIFY: That the attached AS-BUILT SURVEY is correct to the best of my knowledge and belief as recently surveyed under my direction, and meets the intent of the Minimum Technical Standards set forth by the Florida Board of Professional Surveyors and Mappers in Chapter 61G17-6 Florida Administrative Code, pursuant to Section 472.027, Florida.

Michael Carozza      Date  
Professional Surveyor and Mapper  
State of Florida, No. 6965

Not valid without the signature and the original raised seal of a Florida Licensed Surveyor and Mapper.

No.	Date	Description

**VILLAGE OF KEY BISCAIYNE**  
**88 WEST MCINTYRE STREET**  
**KEY BISCAIYNE BLVD. , FL. 33149**

**MPG TECHNICAL GROUP CORP.**  
908 S.W. 141st Avenue, Miami, Florida 33184  
Ph. (305) 559-9043 Fax. (305)559-8914  
No. LB 6932

CHECKED BY: M.C.
DRAWN BY: ELF.
FIELD DATE: 11/24/2016
DATE: 12/07/2016
SCALE: 1" = 20'


SHEET:  
**1**  
OF 2



# Exhibit "B"

## LEGEND

QTY.	KEY	DESCRIPTION	QTY.	KEY	DESCRIPTION
2		KAPOK TREE (50' HT.)	24		ORANGE GLIDER TREE (12' HT.)
18		LIVE OAK (14' HT.)	44		PHOENIX RECLINATA (20' HT.)
87		MAHOGANY (12'-14' HT.)	2		SEAGRAPE (18' HT.)
29		GUMBO LIMBO (16'-18' HT.)	16		ROYAL POINCIANA (16' HT.)
42		YELLOW TABEBUIA (14' HT.)	2		PITHECELLOBIUM (20' HT.)
50		PINK TABEBUIA (14' HT.)	35		PIDGEEON PLUM (12' HT.)
3		SABAL PALM (12' HT.)	2		TAMARIND (14' HT.)
49		COCONUT PALM (18' HT.)	18		LIGHT POLE
7		SATIN LEAF (14' HT.)	30		BENCH

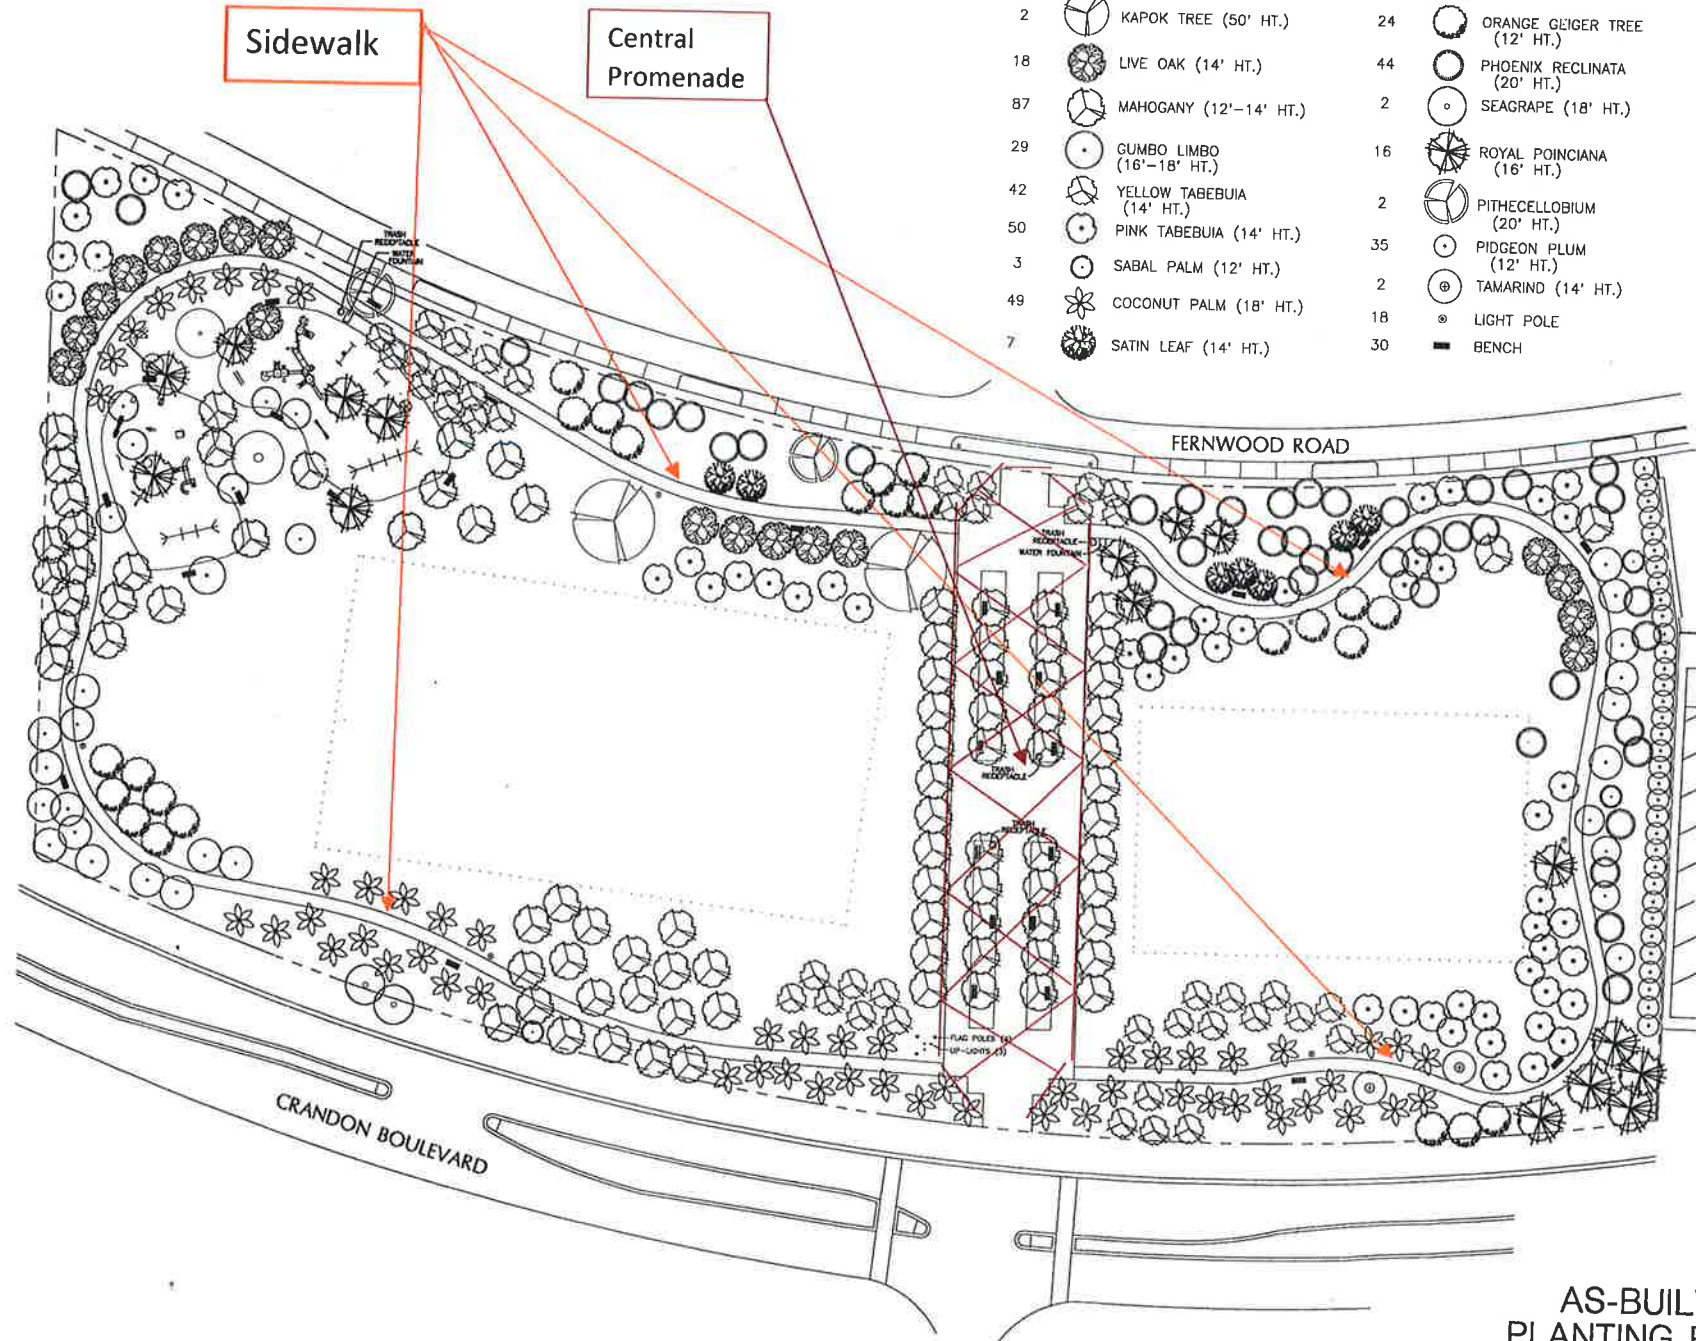

AS-BUILT  
PLANTING PLAN

SCALE: 1" = 40'-0"



TREE FARM PARK  
KEY BISCAIYNE,  
FLORIDA

ODA

O'LEARY DESIGN ASSOCIATES P.A.  
LANDSCAPE ARCHITECTURE LAND PLANNING  
URBAN DESIGN GRAPHIC DESIGN  
8525 S.W. 12TH STREET, SUITE 201, MIAMI, FL 33155  
TEL: (305) 358-0000 FAX: (305) 358-0001

William O'Leary

8-13-96

L-2

DATE: AUG 9, 1996  
SCALE: 1" = 40'-0"